


NORTH

SCALE: 1/8" = 1'-0"

CDL Associates, Inc.

INTERIOR ARCHITECTURE & SPACE PLANNING
3265 Research Drive
Irvine, CA 92618
(949) 679-6456 • Fax (949) 679-6460
E-mail: CDL.ecdlassociates@inc.com

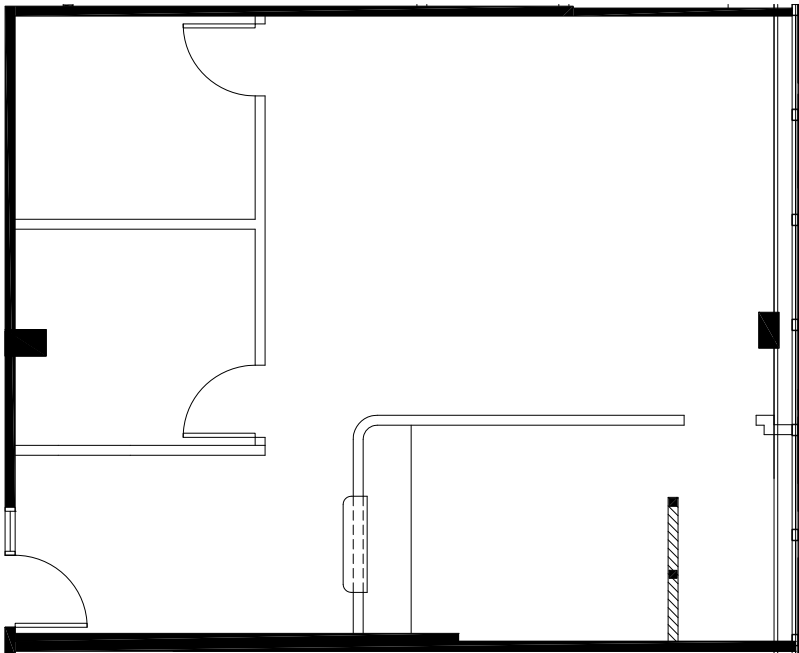

PLAN LAYOUT SUBJECT TO FIELD CONDITIONS. FIELD CONDITIONS MAY DIFFER FROM PLAN AS SHOWN. ALL ROOM SIZES ARE APPROXIMATE. ALL INFORMATION REPRESENTED ON THIS DRAWING IS BELIEVED TO BE ACCURATE. HOWEVER, TENANT SHOULD VERIFY ALL PERTINENT INFORMATION PRIOR TO COMMITTING TO A LEASE. THIS PLAN IS NOT INTENDED FOR CONSTRUCTION PURPOSES AND FURNITURE OR FIXTURES REPRESENTED ON PLAN ARE TO BE PROVIDED BY TENANT AND ARE NOT INTENDED AS PART OF IT.



SUITE 303

23521 PASSEO DE VALENCIA
LAGUNA HILLS, CA
1,018 R. SQ. FT.
04/04/12